
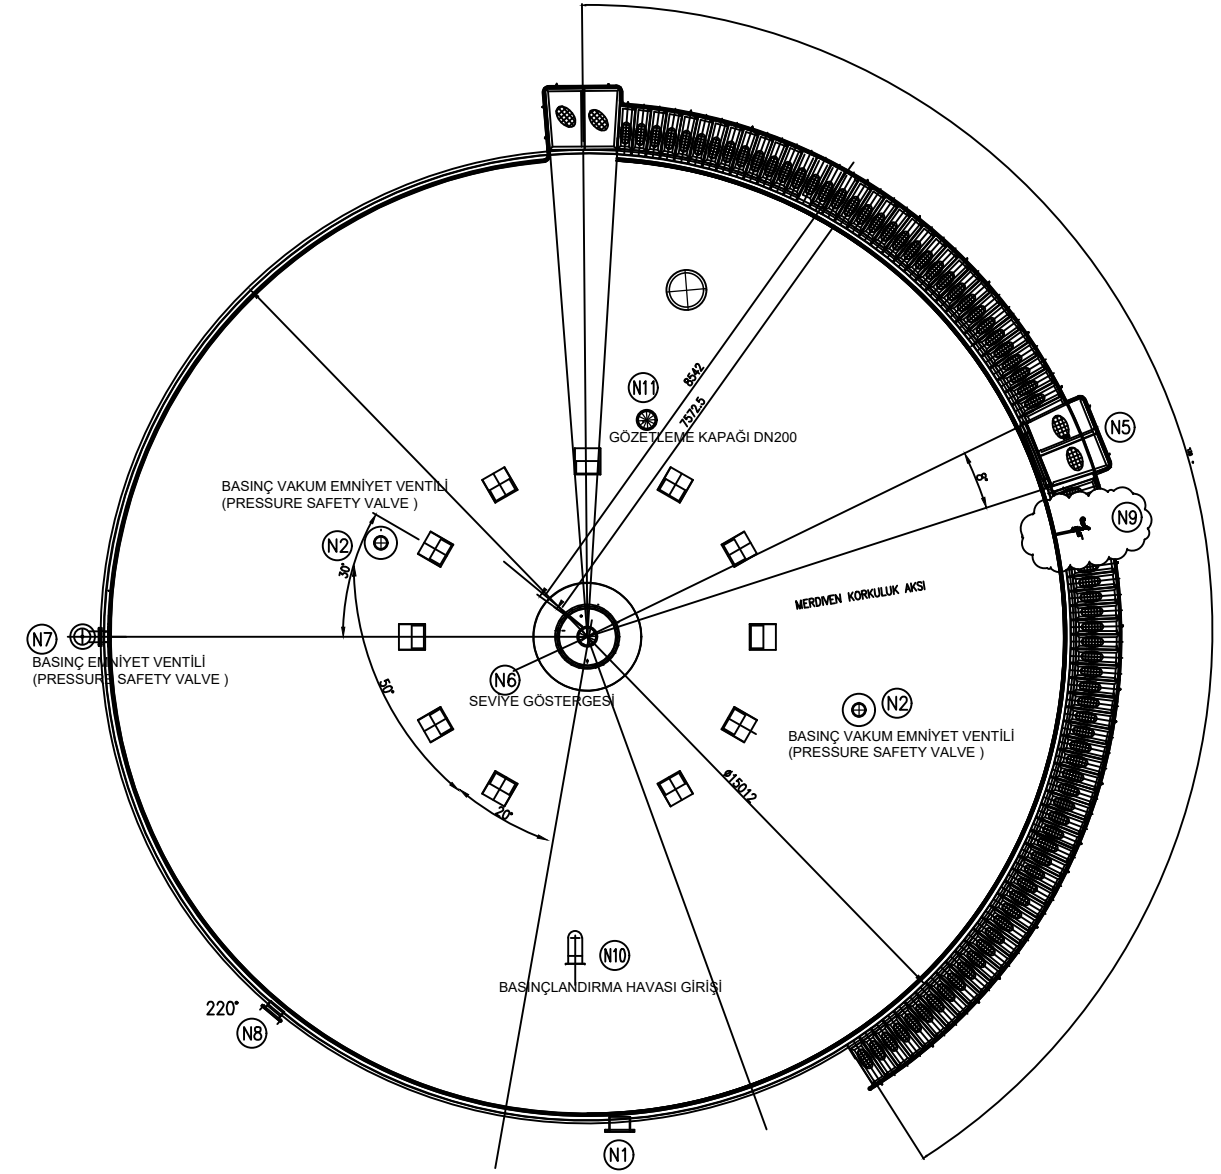


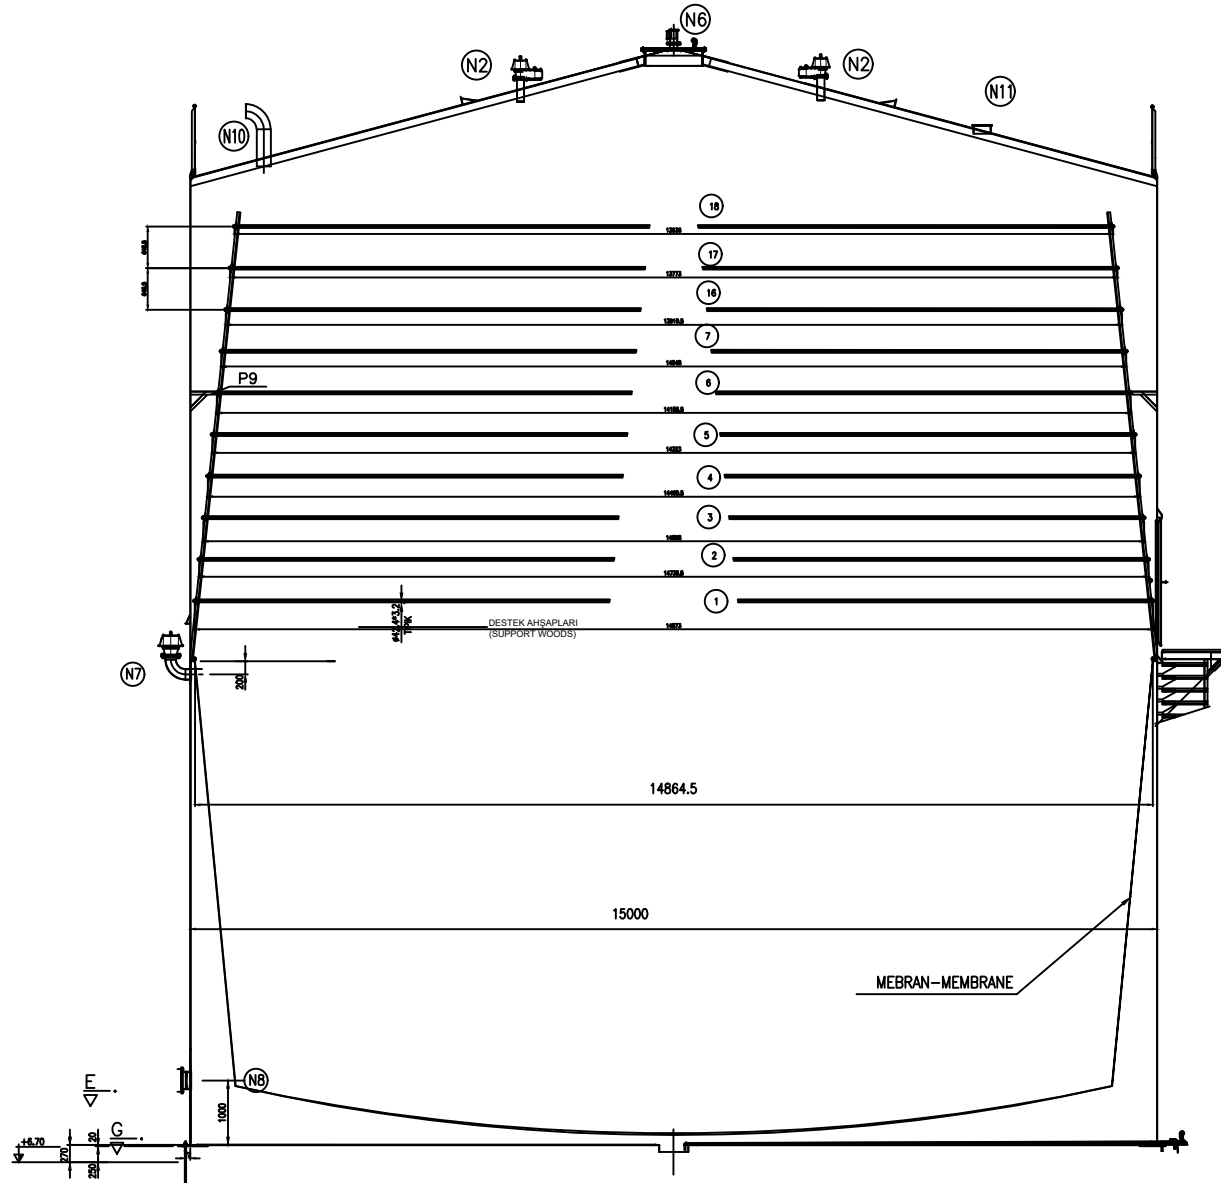

T.C. ANTALYA BÜYÜKŞEHİR BELEDİYESİ
SU VE ATIKSU İDARESİ GENEL MÜDÜRLÜĞÜ
ANTALYA METROPOLITAN MUNICIPALITY
Water And Wastewater Administration General Directorate

HURMA ATIKSU ARITMA TESİSİ GENİŞLETİLMESİ
EXTENSION OF HURMA WASTEWATER TREATMENT PLANT

Onay: ASAT Genel Müdürlüğü
CONTRACT APPROVAL CONTRACTOR

Onay: Proje Yürütme Birimi
ALDAŞ A.Ş.
CONTRACT APPROVAL PROJECT IMPLEMENTATION UNIT

PROJE AŞAĞISI
İŞ SONU ÇİZİMLERİ / AS-BUILT DRAWINGS

ONAY YÖKLENCİ
CONTRACT APPROVAL CONTRACTOR

ONAY MÜHÜRÜ
CONTRACT APPROVAL ENGINEER

YÖKLENCİ
CONTRACTOR

SRD 3K

PROJE ONAY VE DENETİM KALİTE GÜVENCESİ

TARİH/DATE	İSİM/NAME	İMZASI/SIGNATURE	TARİH/DATE	İSİM/NAME	İMZASI/SIGNATURE
KASIM - 2011	EROL DAĞ		KASIM - 2011	CEMİZ ŞAHİD	
KASIM - 2011	EROL DAĞ		KASIM - 2011	MURAT NİL	

EXTENSION OF HURMA WASTEWATER TREATMENT PLANT
HURMA ATIKSU ARITMA TESİSİ GENİŞLETİLMESİ

GAZ DEPOLAMA TANKI GENEL
YERLEŞİM PLANI VE KESİTLERİ
GENERAL ARRANGEMENT OF
LEVEL GAUGE

ÖLÇEK/SCALE: 1/40

RESİM NO/ DRAWING NO: HURMA-46-M-MP-19

REV. NO/ REV. NO: 2