

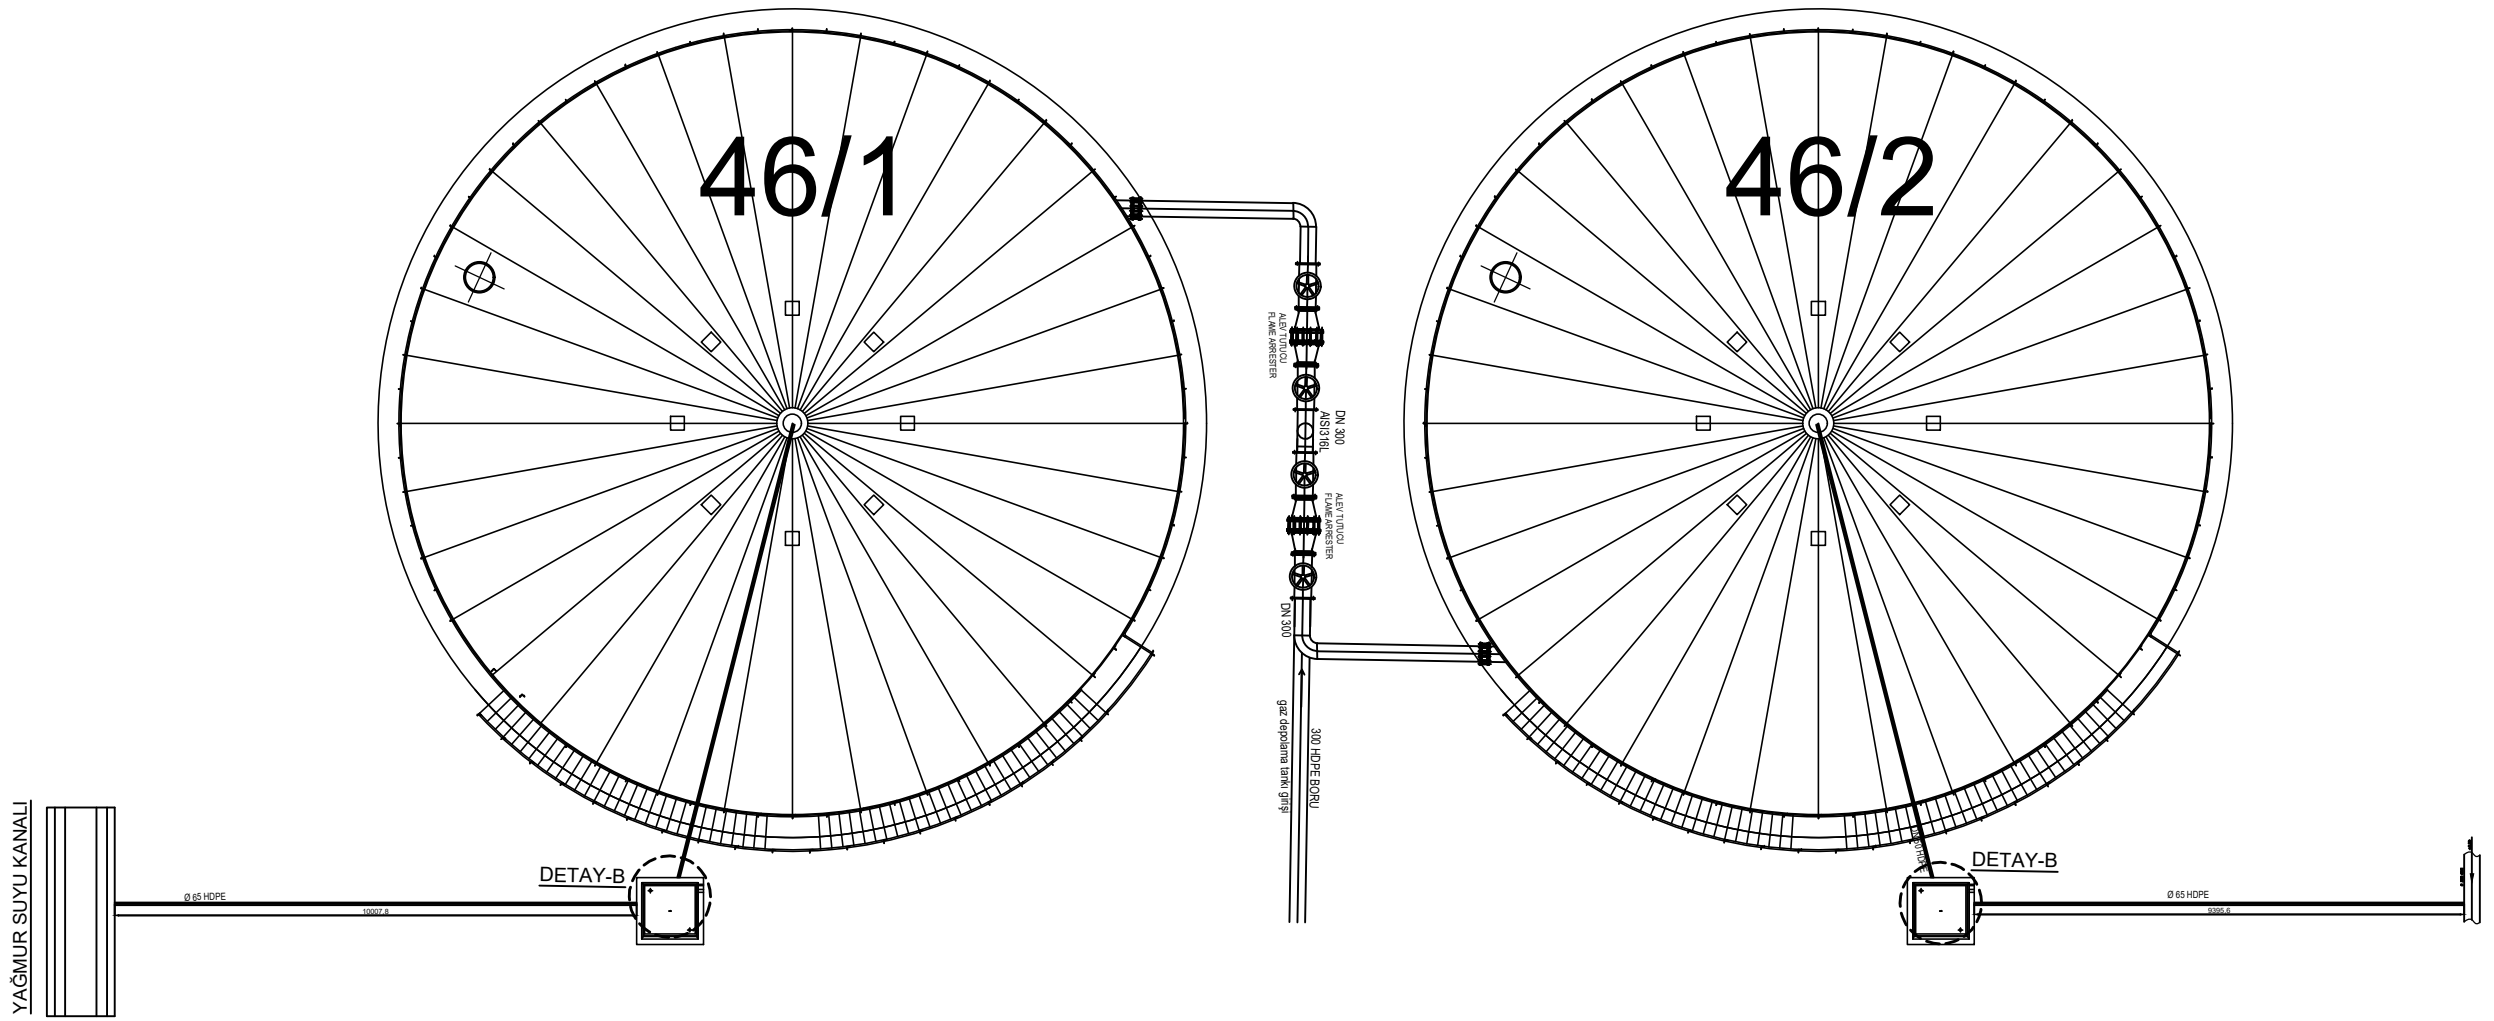
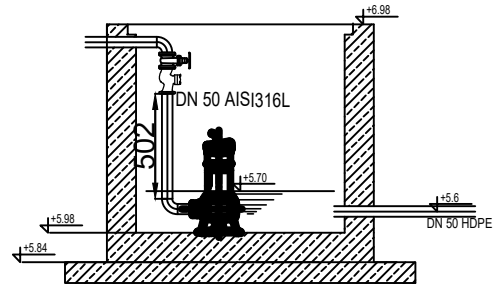


DETAY-B
OLÇEK/SCALE: 1:25

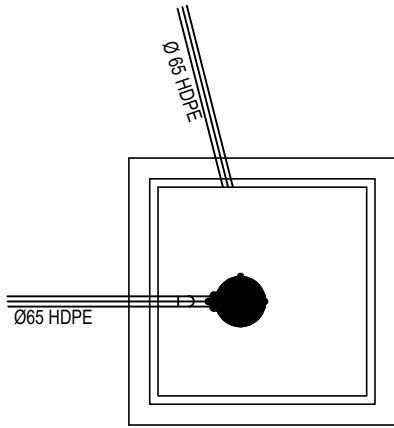

YAĞMUR SUYU KANALI
Ölçek:1/25

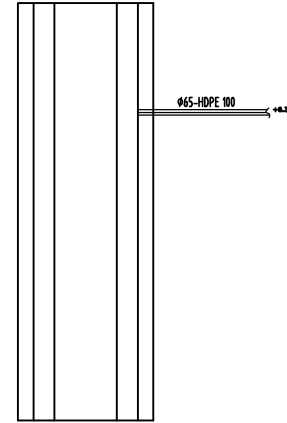

	T.C. ANTALYA BÜYÜKŞEHİR BELEDİYESİ SU VE ATIKSU İDARESİ GENEL MÜDÜRLÜĞÜ				
ANTALYA METROPOLITAN MUNICIPALITY Water And Wastewater Administration General Directorate					
HURMA ATIKSU ARITMA TESİSİ GENİŞLETİLMESİ EXTENSION OF HURMA WASTEWATER TREATMENT PLANT					
Onay: ASAT Genel Müdürlüğü CONTRACT APPROVAL CONTRACTOR			Onay: Proje Yürütme Birimi ALDAŞ A.Ş. CONTRACT APPROVAL PROJECT IMPLEMENTATION UNIT		
PROJE ADI: İŞ SONU ÇİZİMLERİ / AS-BUILT DRAWINGS					
ONAY YÖKLENDİ CONTRACT APPROVAL CONTRACTOR			ONAY MÜHÜRLENDİ CONTRACT APPROVAL ENGINEER		
					
YÖKLENDİ CONTRACTOR			PROJELENDİ DESIGNER		
PROJE ONAY/DESİNER QUALITY ASSURANCE					
YASAMA DESIGNED BY	YASAMA CHECKED BY	YASAMA APPROVED BY	YASAMA DESIGNED BY	YASAMA CHECKED BY	YASAMA APPROVED BY
KASIM - 2011	EROL - 2011	KASIM - 2011	KASIM - 2011	EROL - 2011	KASIM - 2011
EXTENSION OF HURMA WASTEWATER TREATMENT PLANT HURMA ATIKSU ARITMA TESİSİ GENİŞLETİLMESİ					
GAZ DEPOLAMA TANKI DRENAJ POMPASI YERLEŞİMİ GAS HOLDER TANK DRAINAGE PUMPS PLACEMENT					
ÖLÇEK SCALE	1/50	RESİM NO DRAWING NO.	HURMA-46-M-MP-23		REVİZYON REV. NO.
					