


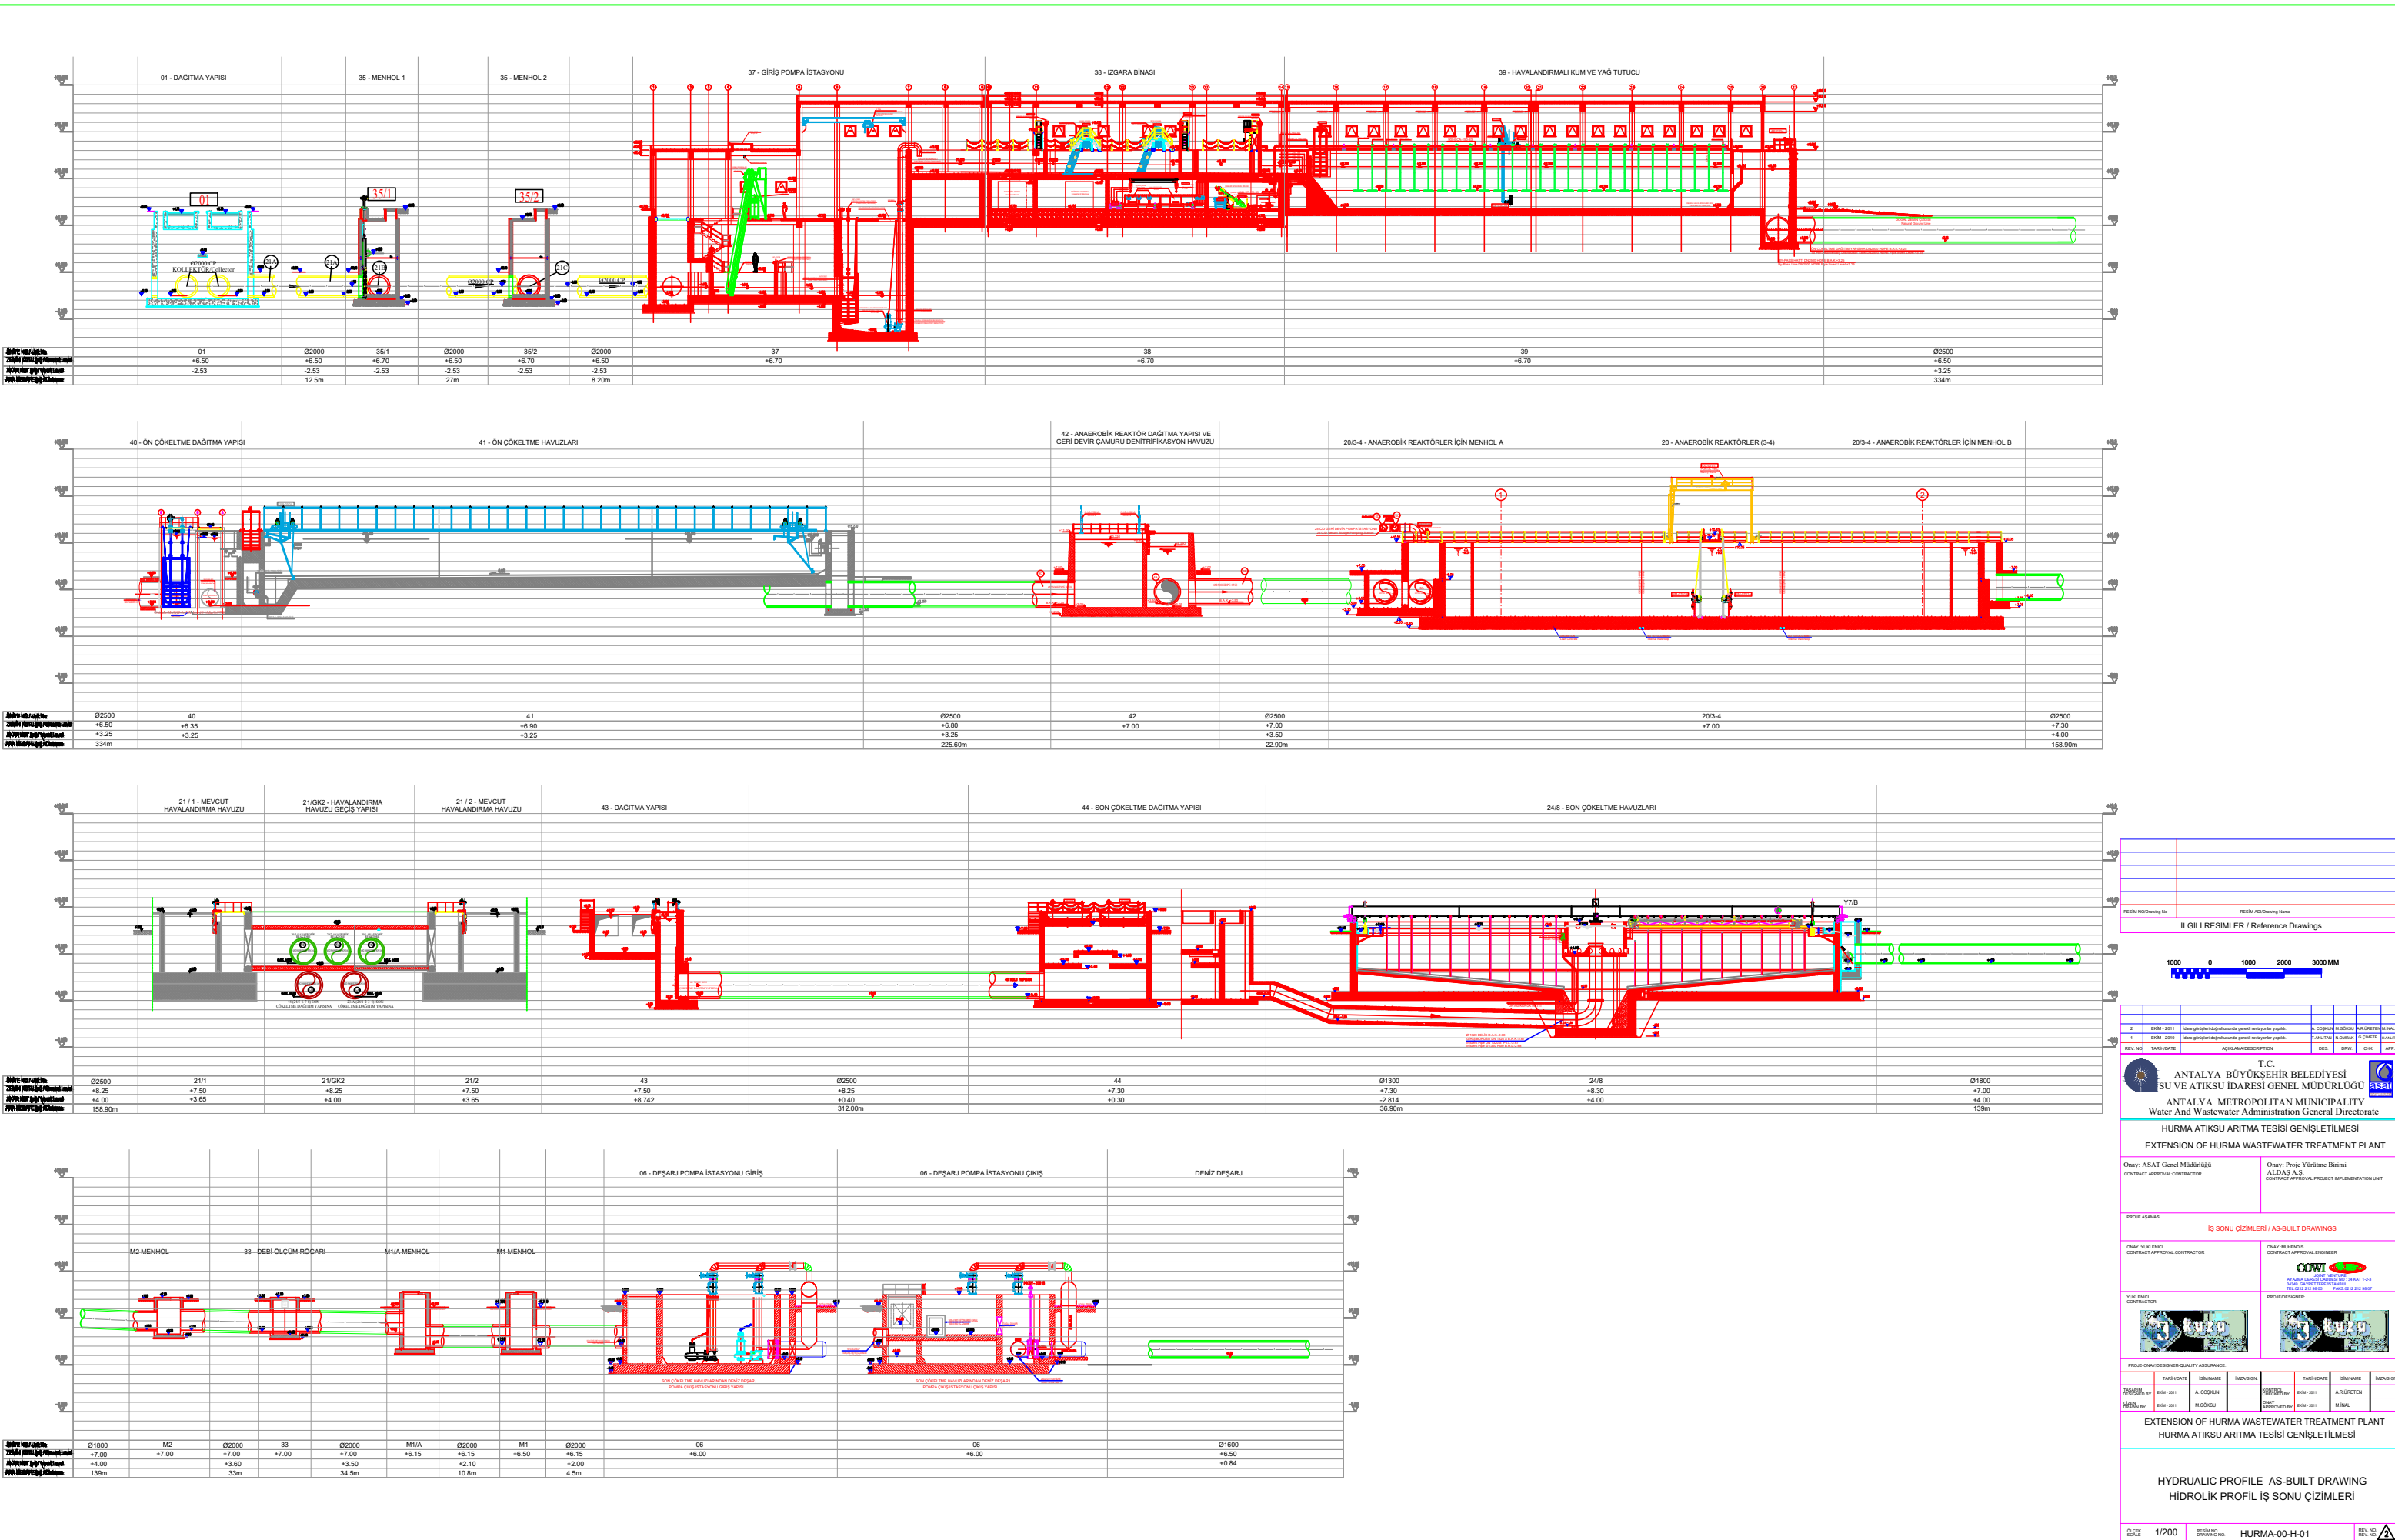

İLGİLİ RESİMLER / Reference Drawings	
1000	0 1000 2000 3000 MM

REV. NO	REV. NO	REV. NO	REV. NO	REV. NO	REV. NO	REV. NO	REV. NO	REV. NO	REV. NO
2	01/01/2011	01/01/2011	01/01/2011	01/01/2011	01/01/2011	01/01/2011	01/01/2011	01/01/2011	01/01/2011
1	01/01/2011	01/01/2011	01/01/2011	01/01/2011	01/01/2011	01/01/2011	01/01/2011	01/01/2011	01/01/2011

ANTALYA BÜYÜKŞEHİR BELEDİYESİ SU VE ATIKSU İDARESİ GENEL MÜDÜRLÜĞÜ ANTALYA METROPOLITAN MUNICIPALITY Water And Wastewater Administration General Directorate					
HURMA ATIKSU ARITMA TESİSİ GENİŞLETİLMESİ EXTENSION OF HURMA WASTEWATER TREATMENT PLANT					
Onay: ASAT Genel Müdürlüğü CONTRACT APPROVAL CONTRACTOR	Onay: Proje Yürütme Birimi ALDAS A.Ş. CONTRACT APPROVAL PROJECT IMPLEMENTATION UNIT				
İŞ SONU ÇİZİMLERİ / AS-BUILT DRAWINGS					
Onay: YATILIMCI CONTRACT APPROVAL CONTRACTOR	Onay: MÜHÜRLEME CONTRACT APPROVAL ENGINEER				
YATILIMCI CONTRACTOR	MÜHÜRLEME CONTRACTOR				
PROJE-ONAY/DESİNER-QUALITY ASSURANCE					
TARİH/DATE	İSİME/NAME	İMZASIN	TARİH/DATE	İSİME/NAME	İMZASIN
01/01/2011	A. COŞKUN		01/01/2011	A. ALİREZİN	
01/01/2011	M. GÖKÇU		01/01/2011	M. BİLAL	
EXTENSION OF HURMA WASTEWATER TREATMENT PLANT HURMA ATIKSU ARITMA TESİSİ GENİŞLETİLMESİ					
HYDRAULIC PROFILE AS-BUILT DRAWING HIDROLİK PROFİL İŞ SONU ÇİZİMLERİ					
ÖLÇEK SCALE	1/200	RESİM NO DRAWING NO	HURMA-00-H-01		REV. NO REV. NO