



THIS DRAWING BELONGS TO SRD-3K INS. LTD.STI.CAN'T BE COPIED AND USED WITH OUT PERMISSION.

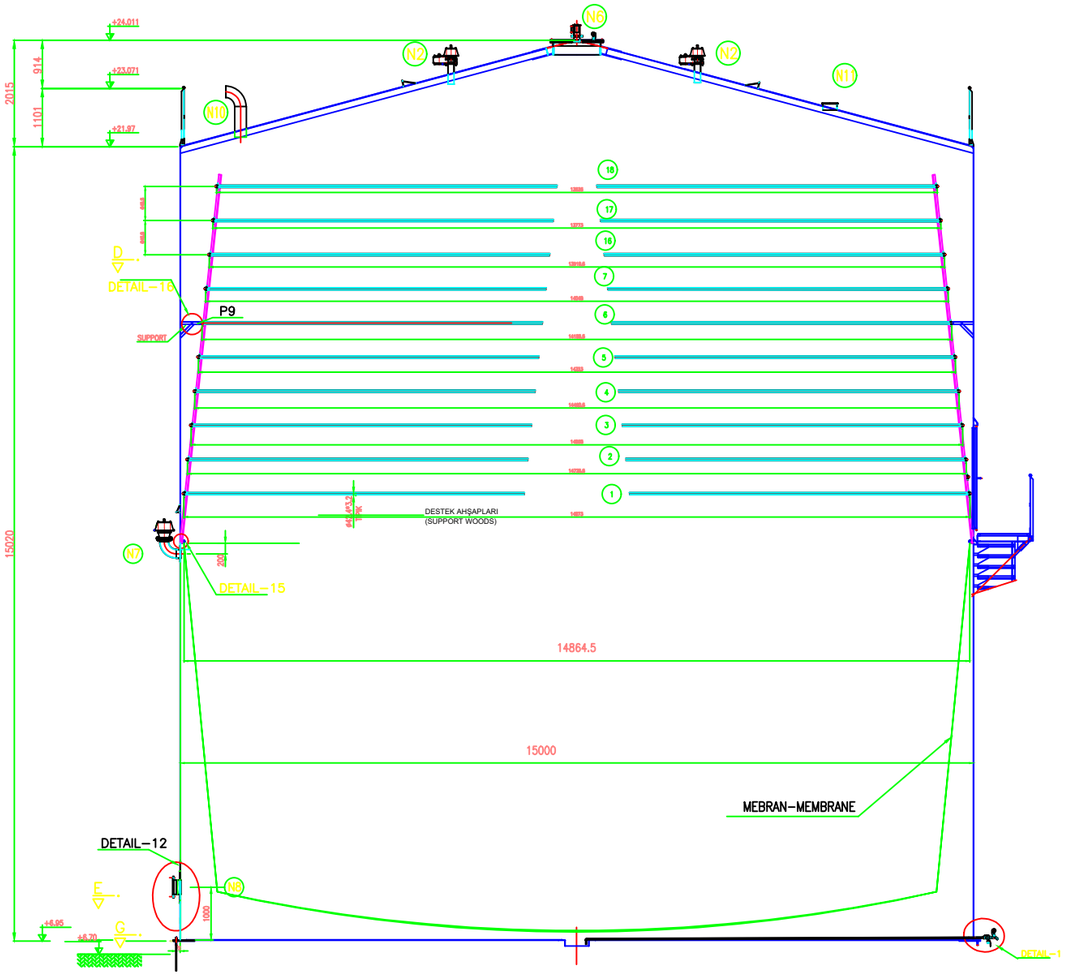


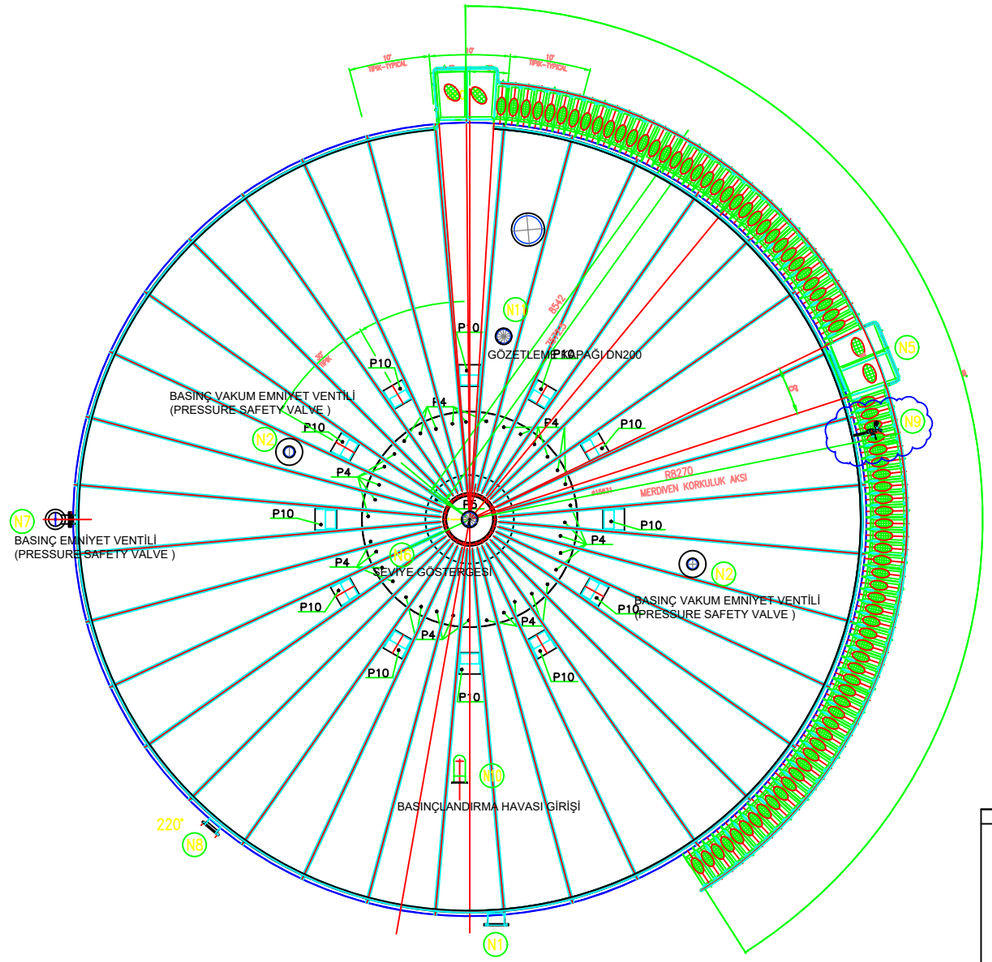

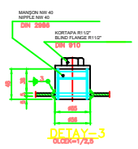


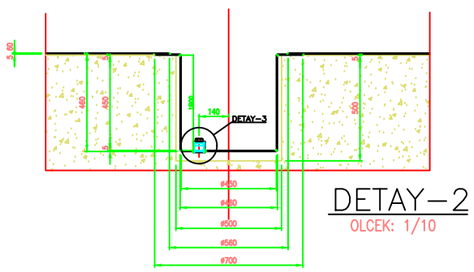

DETAY–2
ÖLÇEK: 1/10

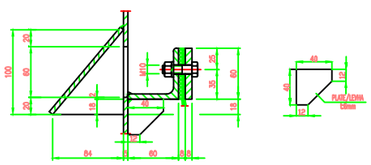

DETAY–15
ÖLÇEK: 1/10

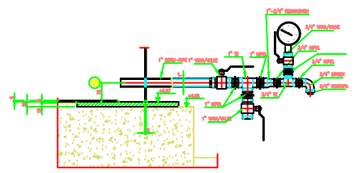

DETAY–1

LADDER, SHELF,BALUSTRADE DETAIL

İLGİLİ RESİM NO(RELATED DWG'S NOS)
HURMA–46–M–MP–16
HURMA–46–M–MP–17
HURMA–46–M–MP–18

İLGİLİ RESMİ NO
RELATED DWG NO:
HURMA–46–M–MP–01
HURMA–46–M–MP–03
HURMA–46–M–MP–04

UNLESS OTHERWISE NOTED ALL DIMENSIONS ARE IN mm
AKSİ BELİRTİLMEDİKÇE TÜM ÖLÇÜLER mm DİR

GENEL NOTLAR/GENERAL NOTES

NOt-1 Tank gövde malzemesi ASTM A 283 GR C / S235 JR(ST 37.2) kalitesinde olacaktır.

Membranın bağlantı civataları takviyeli kauçuktan imal edilecektir.
Belirtilmeyen kaynaklar sürekli olacaktır.
Belirtilmeyen kaynak kalınlıkları , ince elemanın 0,7 si kadar olacaktır. (a=0,7xtmin)
Kaynak kalınlıkları 3 mm den az olmayacaktır.
Tüm çelik elemanlar SA 2 1/2" kalitesinde kumlanacak ve 200 mikron epoksi ile boyanacaktır
Bütün kaynaklar sızdırmaz olacaktır. Taban sızdırmazlık testine tabi tutulacaktır.
Kaynak verileri : DIN 1912 ; TS-1987 , ISO -2553-1984

Note-1 :Tank body material will be ASTM A 283 GR C / S235 JR (ST 37.2) quality

The membrane connection bolts will be made of reinforced rubber.
All Weldins will be continuous unless otherwise stated is not
Not specify the weld thickness, thin element will be up to 0.7 (a=0,7xtmin)
All weld thickness will not be less than 3 mm
All steel components will be sand blasting according to SA 2 1 / 2 " quality and will be (internal and external surface) painted with 200 microns epoxy
All welds will be tight. Tank bottom will be leakage test
Welding standart : DIN 1912 ; TS-1987 , ISO -2553-1984

T.C.
ANTALYA BÜYÜKŞEHİR BELEDİYESİ
SU VE ATIKSU İDARESİ GENEL MÜDÜRLÜĞÜ
ANTALYA METROPOLITAN MUNICIPALITY
Water And Wastewater Administration General Directorate

HURMA ATIKSU ARITMA TESİSİ GENİŞLETİLMESİ
EXTENSION OF HURMA WASTEWATER TREATMENT PLANT

Onay: ASAT Genel Müdürlüğü
CONTRACT APPROVAL CONTRACTOR

Onay: Proje Yürütme Birimi
ALDAŞ A.Ş.
CONTRACT APPROVAL PROJECT IMPLEMENTATION UNIT

PROJE AŞAMASI
İŞ SONU ÇİZİMLERİ / AS-BUILT DRAWINGS

ONAY: YÜKLENİCİ
CONTRACT APPROVAL CONTRACTOR

ONAY: MÜHENDİS
CONTRACT APPROVAL ENGINEER
COWI
COWI VENTURE
AYAZMA DERESİ CADDESİ NO: 34 KAT 1-2-3
34349, GAYRETTEPE/İSTANBUL
TEL:0212 2128 000 FAKS:0212 2128 007

YÜKLENİCİ
CONTRACTOR

PROJE/İŞ GRUBU
SRD 3K

PROJE-ONAY/DESIGNER-QUALITY ASSURANCE:

	TARİH/DATE	İSİM/NAME	İMZA/SIGN.		TARİH/DATE	İSİM/NAME	İMZA/SIGN.
TASARIM/ DESIGNED BY	KASIM - 2013	EROL DAĞ		KONTROL/ CHECKED BY	KASIM - 2011	CENGİZ ŞAŞO	
ÇİZEN/ DRAWN BY	KASIM - 2011	EROL DAĞ		ONAY/ APPROVED BY	KASIM - 2011	MURAT İNAL	

EXTENSION OF HURMA WASTEWATER TREATMENT PLANT
HURMA ATIKSU ARITMA TESİSİ GENİŞLETİLMESİ

GAZ DEPOLAMA TANKI GENEL YERLEŞİM PLANI VE KESİTLERİ

GENERAL LAYOUT AND NOZZLE AND OTHER DETAIL SECTION

ÖLÇEK / SCALE: 1/40
RESİM NO / DRAWING NO: HURMA-46-M-MP-02
REV. NO / REV. NO: 4