
THIS DRAWING BELONGS TO SRD-3K
INS. LTD.STI.CAN'T BE COPIED
AND USED WITH OUT PERMISSION.

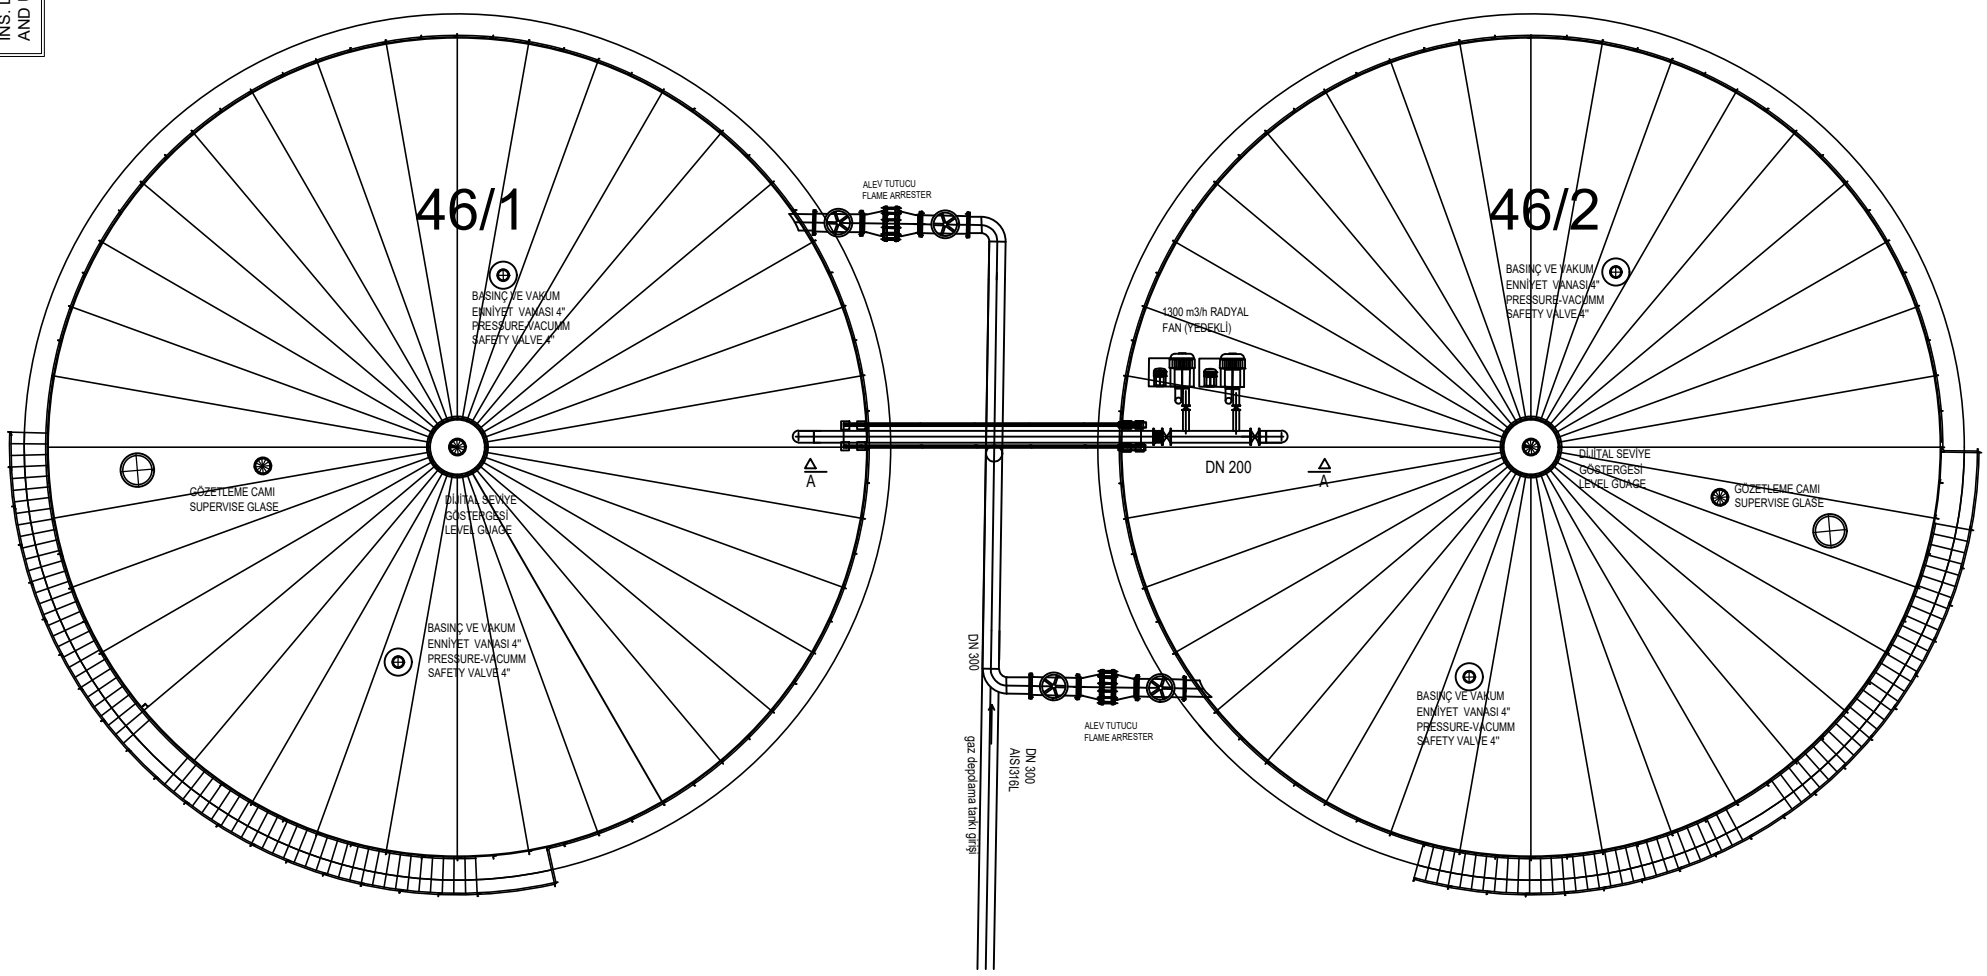



A-A KESİTİ

T.C.
ANTALYA BÜYÜKŞEHİR BELEDİYESİ
SU VE ATIKSU İDARESİ GENEL MÜDÜRLÜĞÜ
ANTALYA METROPOLITAN MUNICIPALITY
Water And Wastewater Administration General Directorate

HURMA ATIKSU ARITMA TESİSİ GENİŞLETİLMESİ
EXTENSION OF HURMA WASTEWATER TREATMENT PLANT

Onay: ASAT Genel Müdürlüğü
CONTRACT APPROVAL:CONTRACTOR

Onay: Proje Yürütme Birimi
ALDAŞ A.Ş.
CONTRACT APPROVAL:PROJECT IMPLEMENTATION UNIT

PROJE AŞAMASI
İŞ SONU ÇİZİMLERİ / AS-BUILT DRAWINGS

ONAY :YÜKLENİCİ
CONTRACT APPROVAL:CONTRACTOR

ONAY :MÜHENDİS
CONTRACT APPROVAL:ENGINEER

ODWI
JOINT VENTURE
AYAZMA DERESİ CADDESİ NO : 34 KAT 1-2-3
34349 GAYRETTEPE/İSTANBUL
TEL:0212 212 98 05 FAKS:0212 212 98 07

YÜKLENİCİ
CONTRACTOR

PROJE/DESIGNER:
SRD 3K

PROJE-ONAY/DESIGNER-QUALITY ASSURANCE:

	TARİH/DATE	İSİM/NAME	İMZA/SIGN.		TARİH/DATE	İSİM/NAME	İMZA/SIGN.
TASARIM DESIGNED BY	KASIM - 2011	EROL DAĞ		KONTROL CHECKED BY	KASIM - 2011	CENGİZ ŞAŞO	
ÇİZEN DRAWN BY	KASIM - 2011	EROL DAĞ		ONAY APPROVED BY	KASIM - 2011	MURAT İNAL	

EXTENSION OF HURMA WASTEWATER TREATMENT PLANT
HURMA ATIKSU ARITMA TESİSİ GENİŞLETİLMESİ

GAZ DEPOLAMA TANKI
BORU BAĞLANTI DETAYLARI
GAS HOLDER TANK PIPE CONNECTION DETAIL

ÖLÇEK SCALE 1/50
RESİM NO. DRAWING NO. HURMA-46-M-MP-20
REV. NO. REV. NO. 2